



GENERAL NOTES:  
 AREA - MAIN FLOOR = 614 FT<sup>2</sup>  
 SEC. FLOOR = 337 FT<sup>2</sup>  
 TOTAL AREA = 951 FT<sup>2</sup>

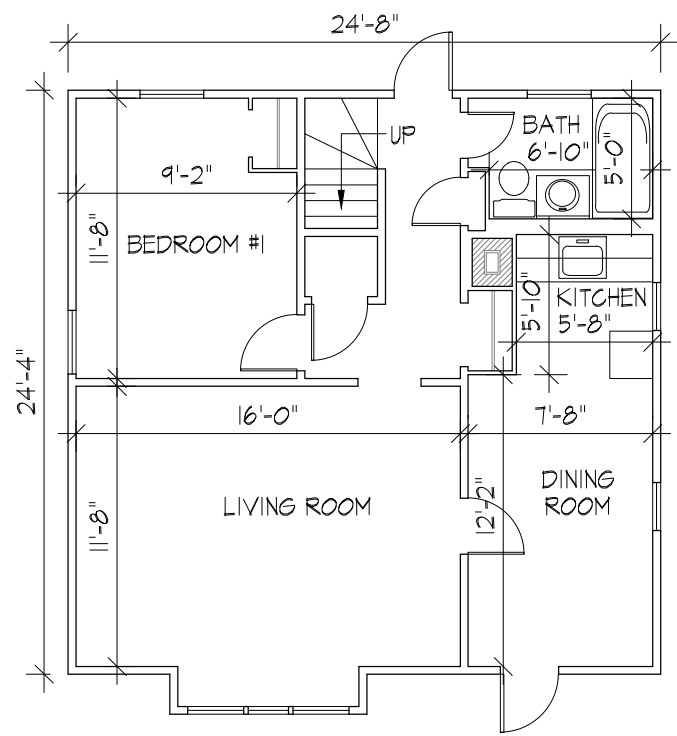

1 FIRST FLOOR PLAN  
 SCALE 1/8" = 1'-0"

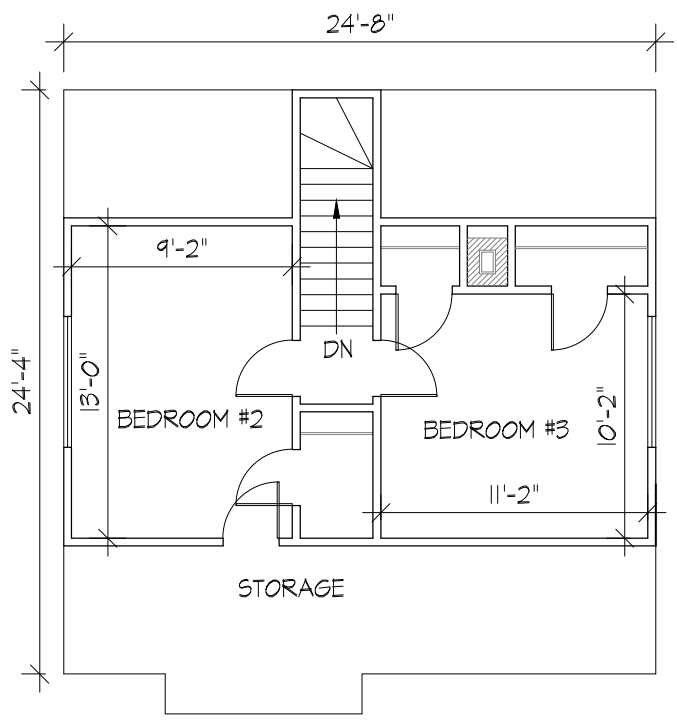

2 SECOND FLOOR PLAN  
 SCALE 1/8" = 1'-0"

TYPE C & CC  
 THREE BEDROOM SMALL HOUSE OR DUPLEX



SLEMON PARK CORPORATION

PROJECT NAME:  
 AS BUILT DRAWINGS

BUILDING TYPE: THREE BEDROOM SMALL HOUSE OR DUPLEX	SHEET NAME: FLOOR PLANS
---	----------------------------

DRAWN BY: M. STOREY	SCALE: 1/8" = 1'-0"
------------------------	------------------------

DATE: AUG. 20 2009	REVISED ON:
-----------------------	-------------