



GENERAL NOTES:
 AREA - MAIN FLOOR = 560 FT²
 SEC. FLOOR = 560 FT²
 TOTAL AREA = 1,120 FT²

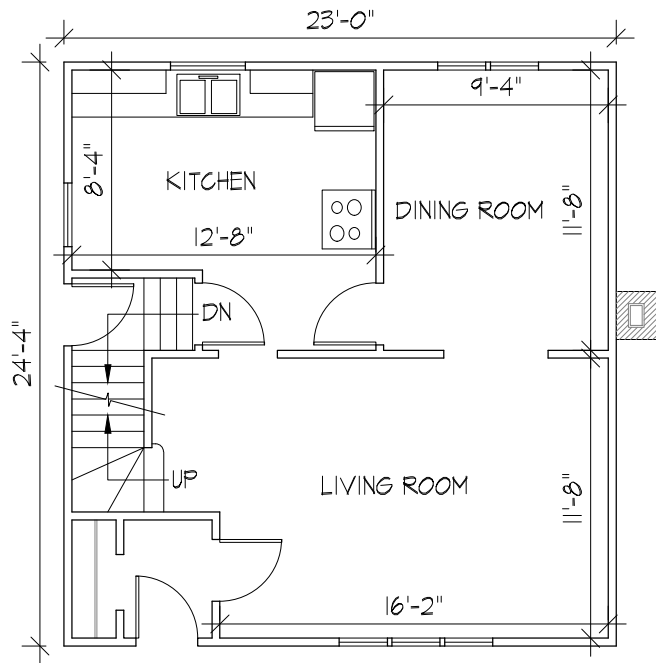

1 FIRST FLOOR PLAN
 SCALE 1/8" = 1'-0"

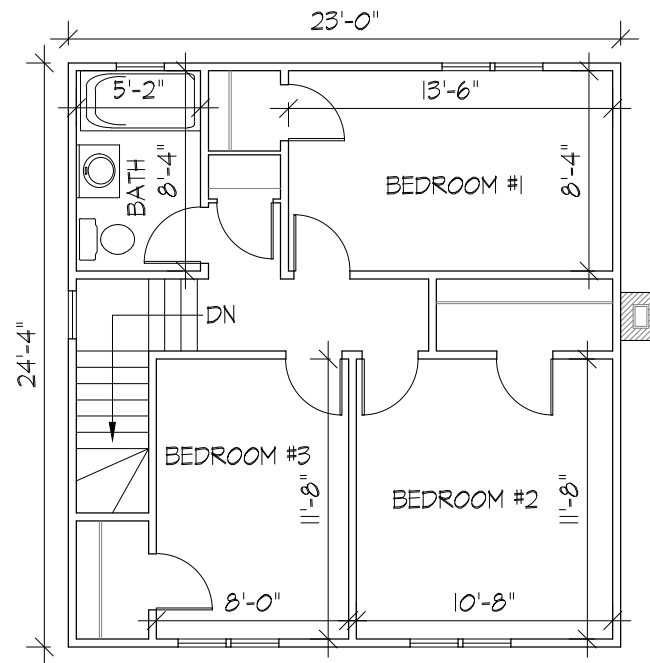

2 SECOND FLOOR PLAN
 SCALE 1/8" = 1'-0"

TYPE J & JJ
 THREE BEDROOM HOUSE OR DUPLEX



SLEMMON PARK
 CORPORATION

PROJECT NAME:

AS BUILT DRAWINGS

BUILDING TYPE:
 THREE BEDROOM
 HOUSE OR DUPLEX

SHEET NAME:
 FLOOR PLANS

DRAWN BY:
 M. STOREY

SCALE:
 1/8" = 1'-0"

DATE:
 AUG. 21. 2009

REVISED ON: