



GENERAL NOTES:

AREA - MAIN FLOOR = 780 FT²
 SEC. FLOOR = 780 FT²
 TOTAL AREA = 1,560 FT²

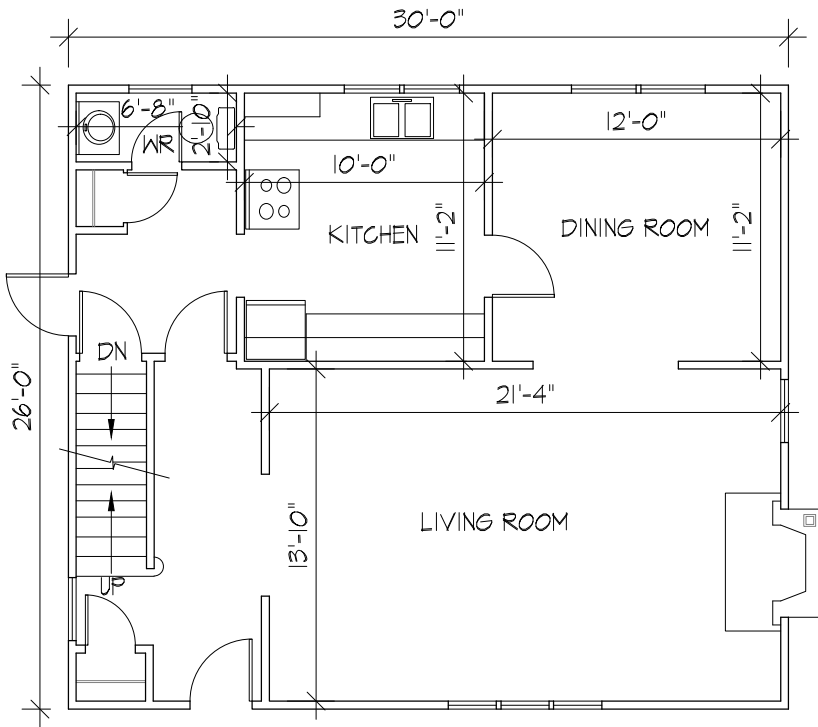

1 FIRST FLOOR PLAN
 SCALE 1/8" = 1'-0"

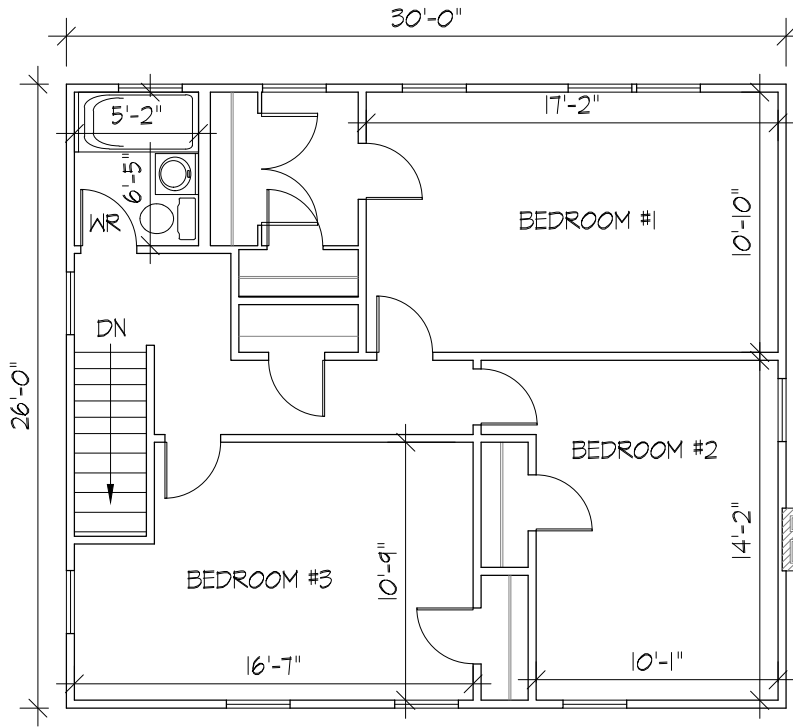

2 SECOND FLOOR PLAN
 SCALE 1/8" = 1'-0"

TYPE Y & YY
 THREE BEDROOM LARGE HOUSE



PROJECT NAME:
AS BUILT DRAWINGS

BUILDING TYPE: THREE BEDROOM LARGE HOUSE	SHEET NAME: FLOOR PLANS
DRAWN BY: M. STOREY	SCALE: 1/8" = 1'-0"
DATE: AUG. 25 2009	REVISED ON: