



GENERAL NOTES:
 AREA - MAIN FLOOR = 632 FT²
 SEC. FLOOR = 632 FT²
 TOTAL AREA = 1,264 FT²

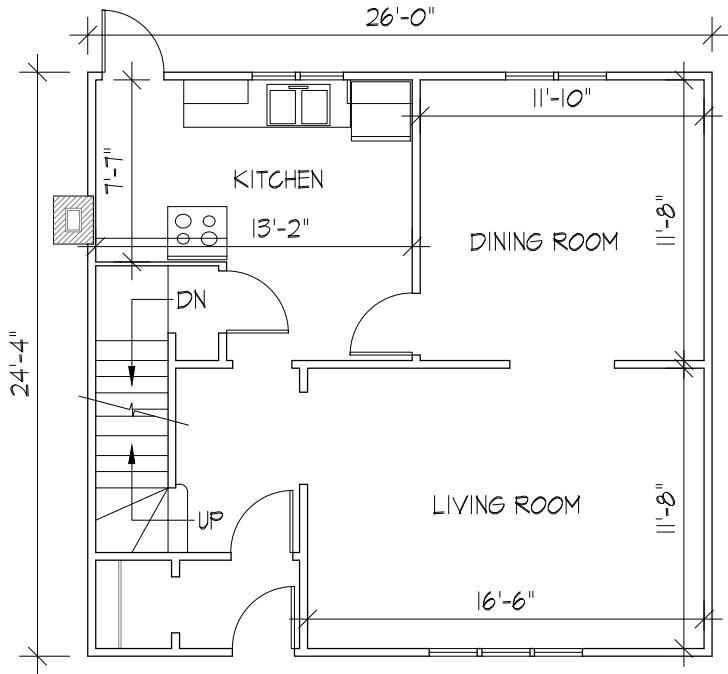

① FIRST FLOOR PLAN
 SCALE 1/8" = 1'-0"

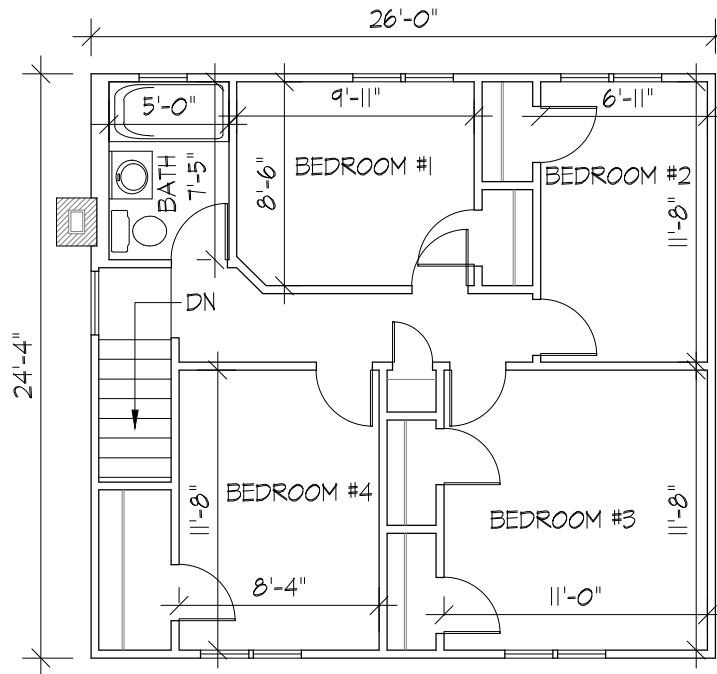

② SECOND FLOOR PLAN
 SCALE 1/8" = 1'-0"

TYPE K & KK
 FOUR BEDROOM HOUSE OR DUPLEX



SLEMON PARK
 CORPORATION

PROJECT NAME:

AS BUILT DRAWINGS

BUILDING TYPE:
 FOUR BEDROOM
 HOUSE OR DUPLEX

SHEET NAME:
 FLOOR PLANS

DRAWN BY:
 M. STOREY

SCALE:
 1/8" = 1'-0"

DATE:
 AUG. 21 2009

REVISED ON: