



GENERAL NOTES:

AREA - MAIN FLOOR = 765 FT<sup>2</sup>  
 SEC. FLOOR = 765 FT<sup>2</sup>  
 TOTAL AREA = 1530 FT<sup>2</sup>

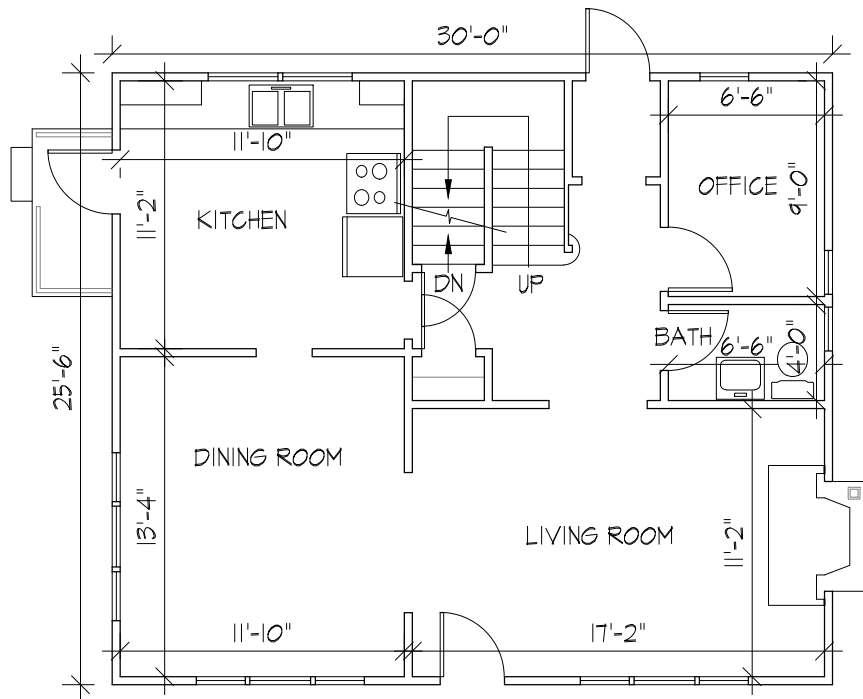

1 FIRST FLOOR PLAN  
 SCALE 1/8" = 1'-0"

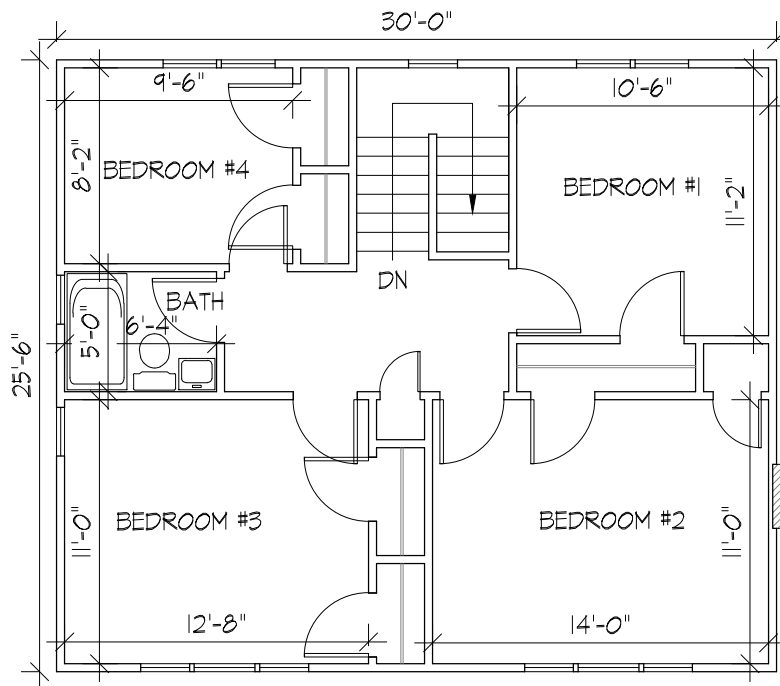

2 SECOND FLOOR PLAN  
 SCALE 1/8" = 1'-0"

TYPE S & SS  
 FOUR BEDROOM LARGE HOUSE



**SLEMMON PARK**  
 CORPORATION

PROJECT NAME:

AS BUILT DRAWINGS

BUILDING TYPE:

SHEET NAME:

FOUR BEDROOM  
 LARGE HOUSE

FLOOR PLANS

DRAWN BY:

SCALE:

M. STOREY

1/8" = 1'-0"

DATE:

REVISED ON:

AUG. 24 2009